



# Interior Plan

## First Floor

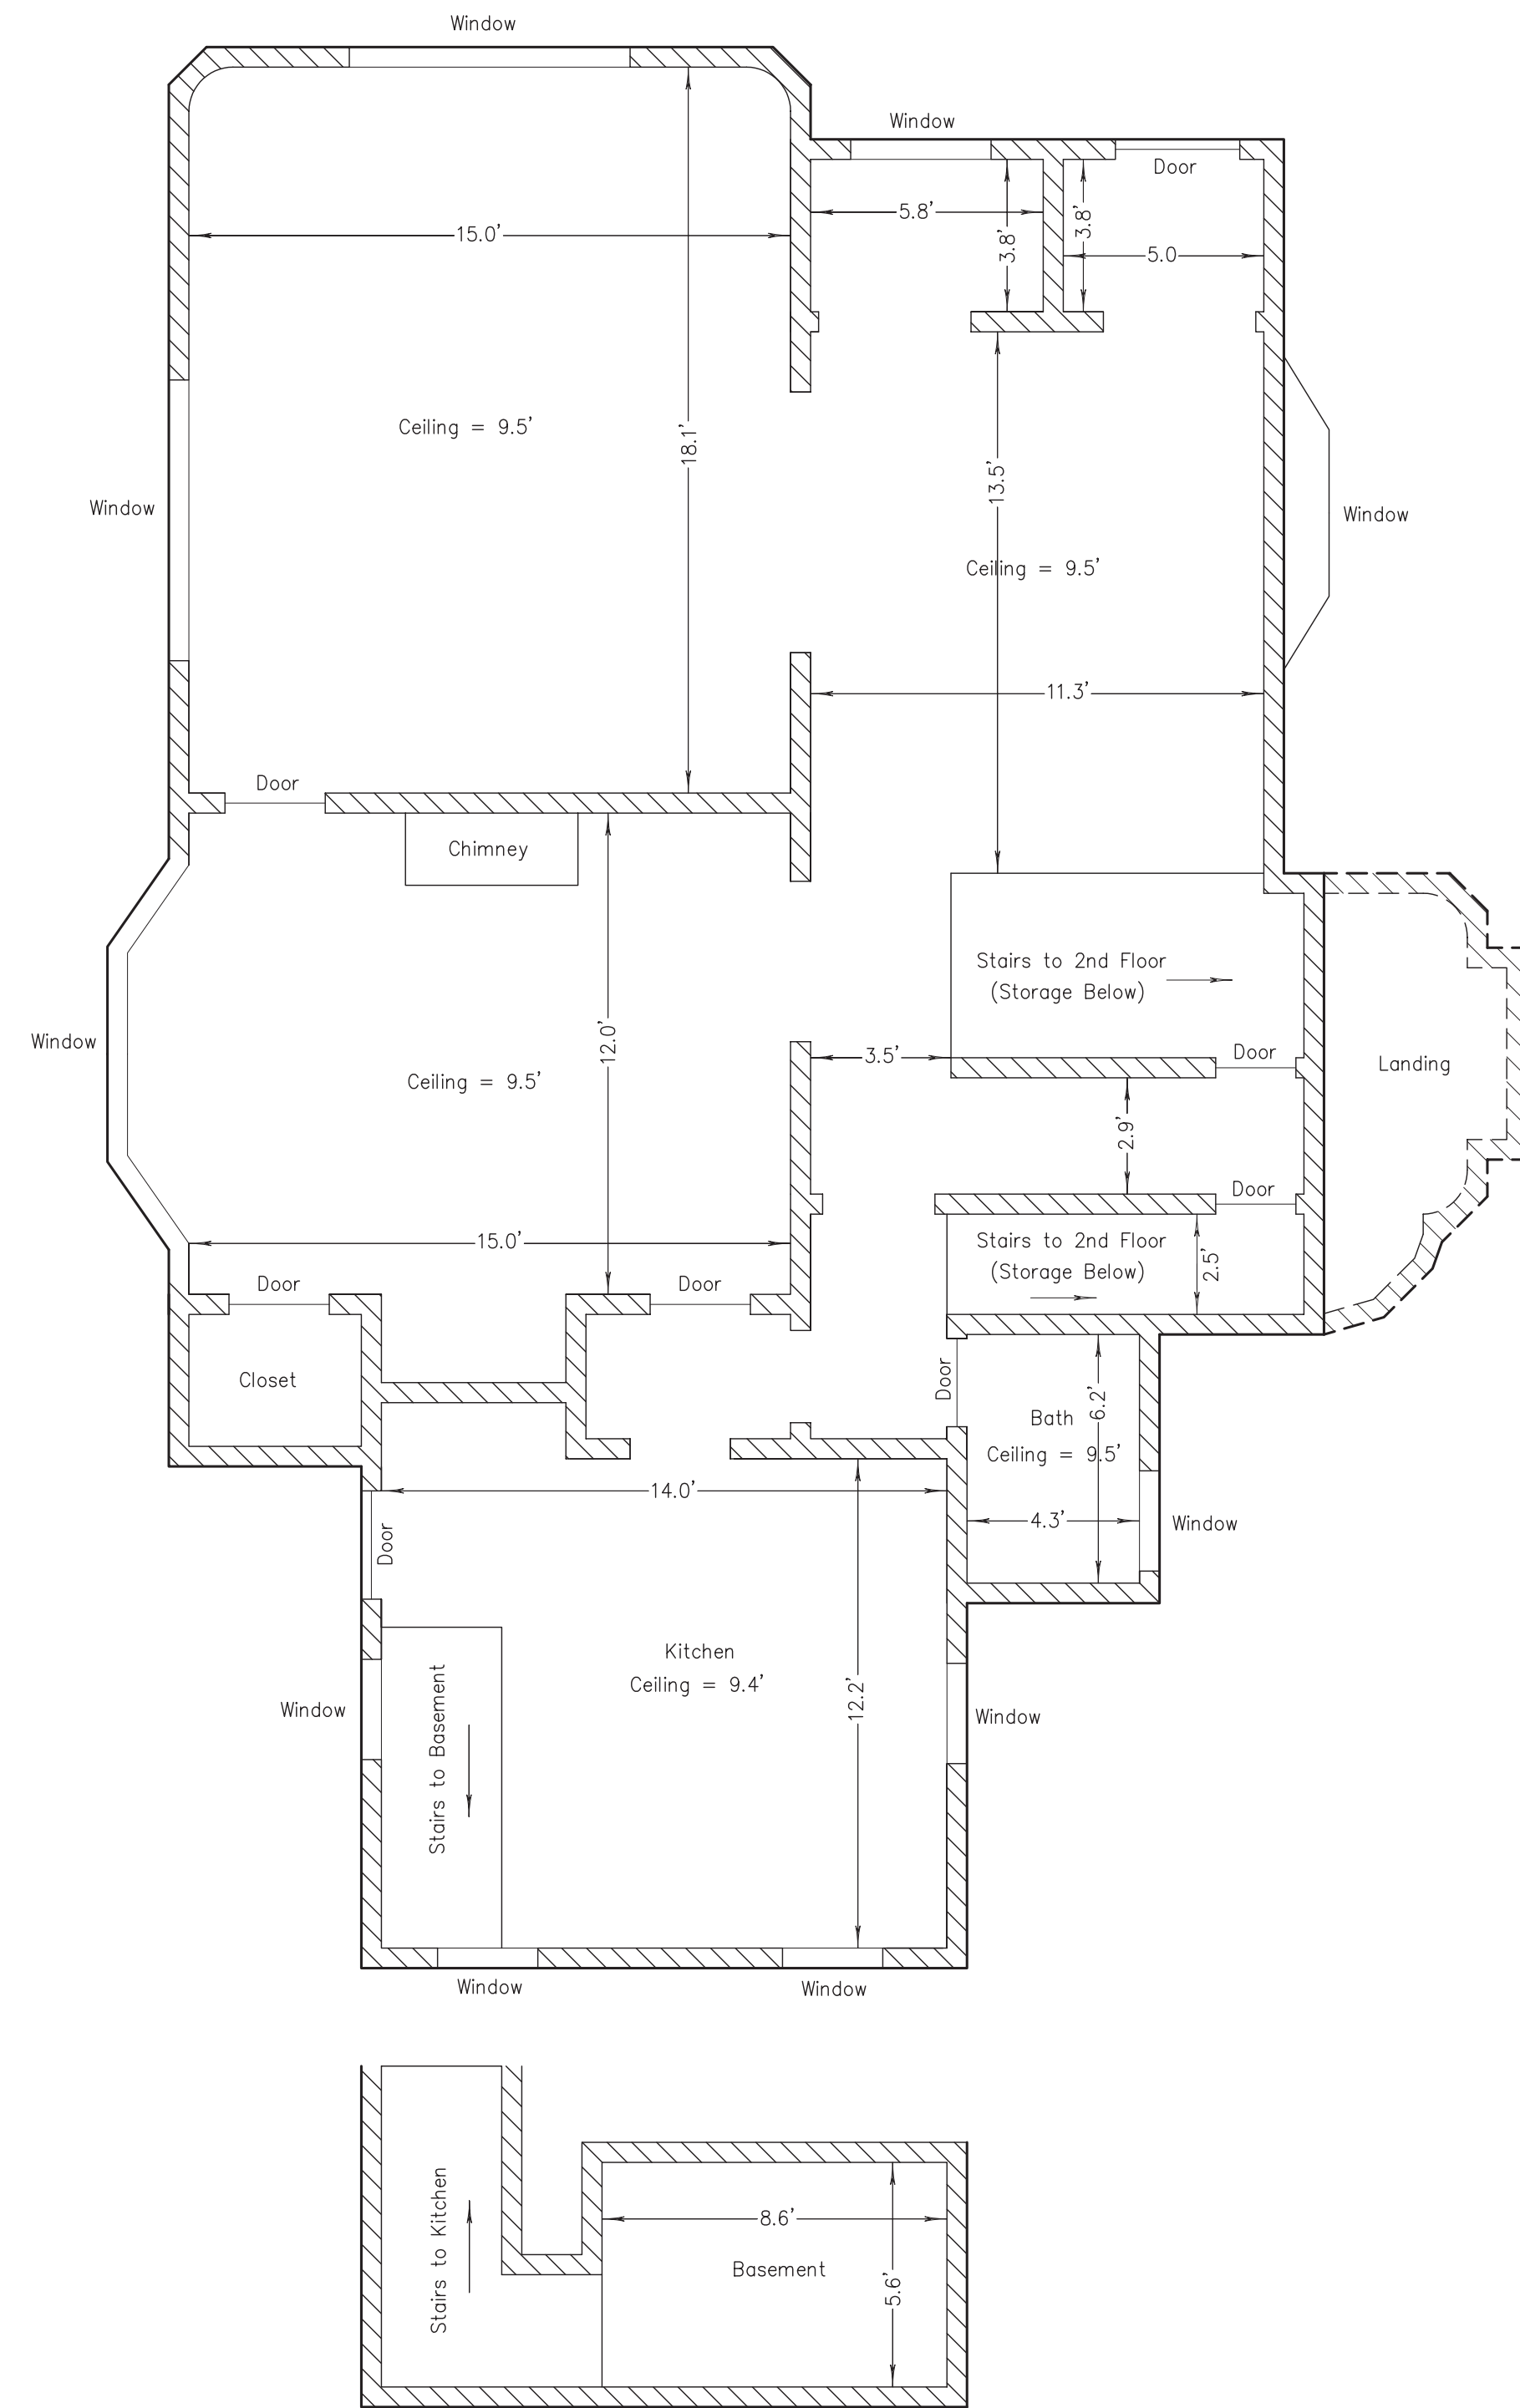

## Second Floor

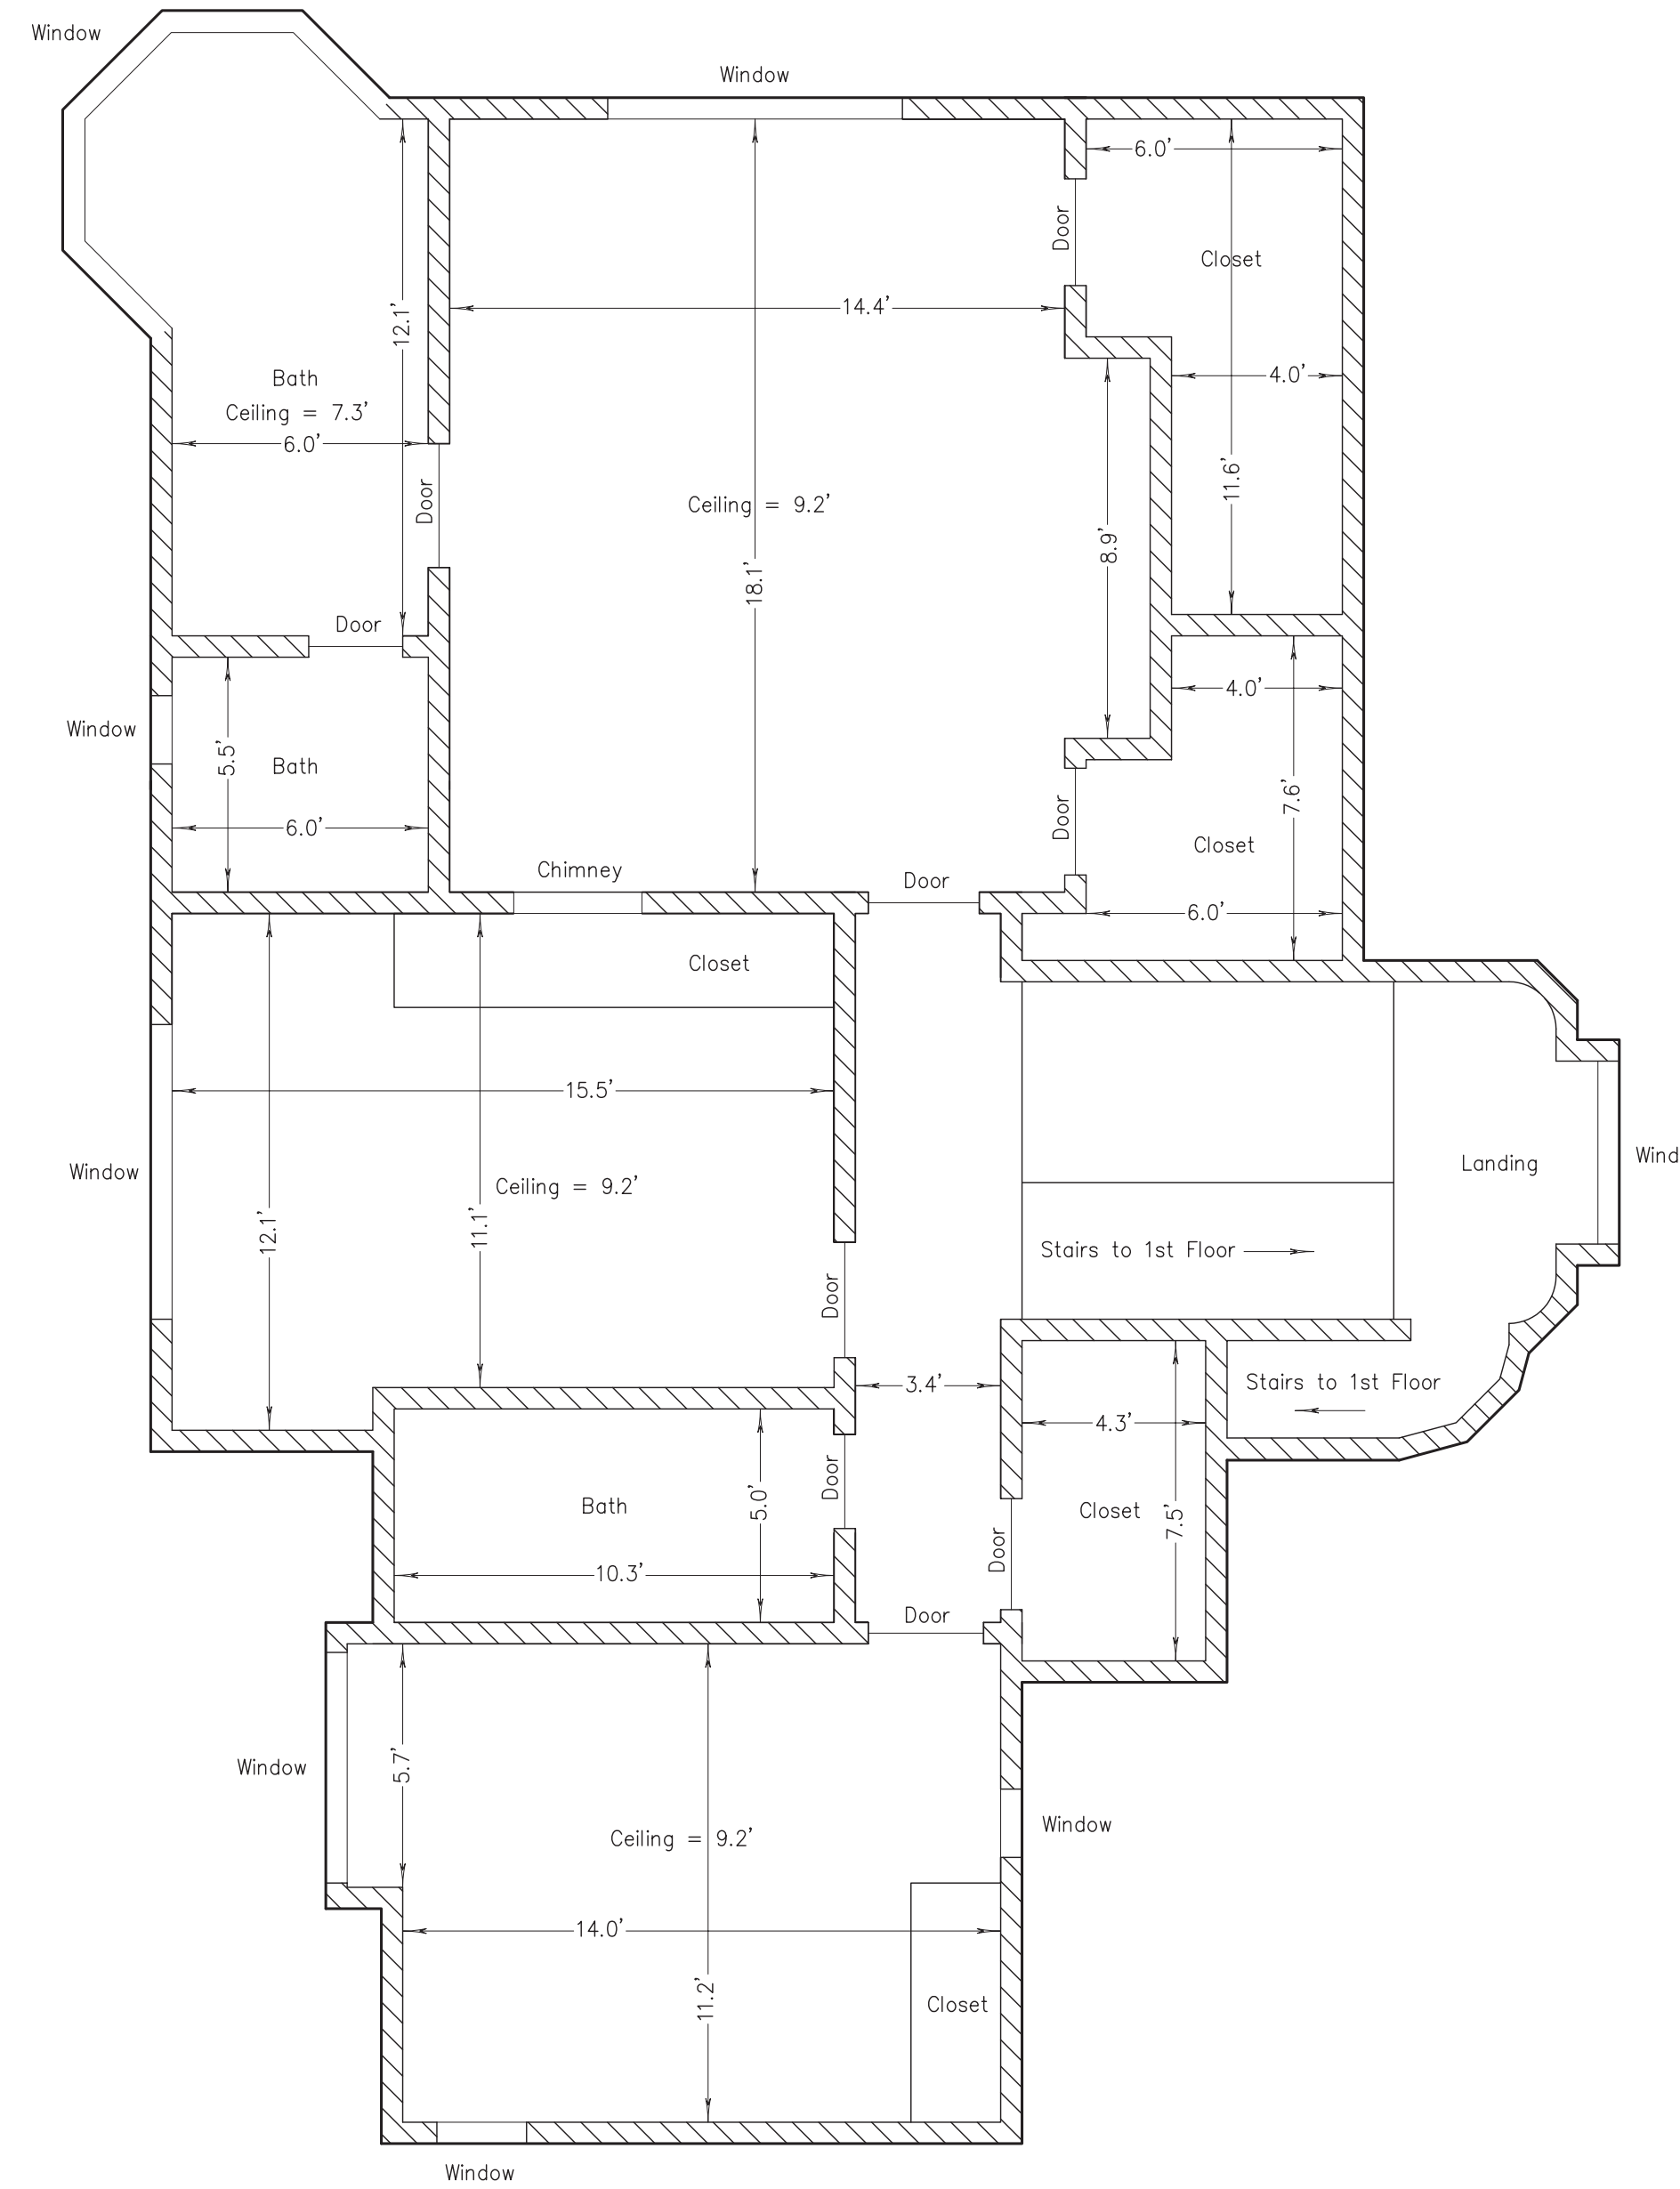

Scale: 1" = 4'